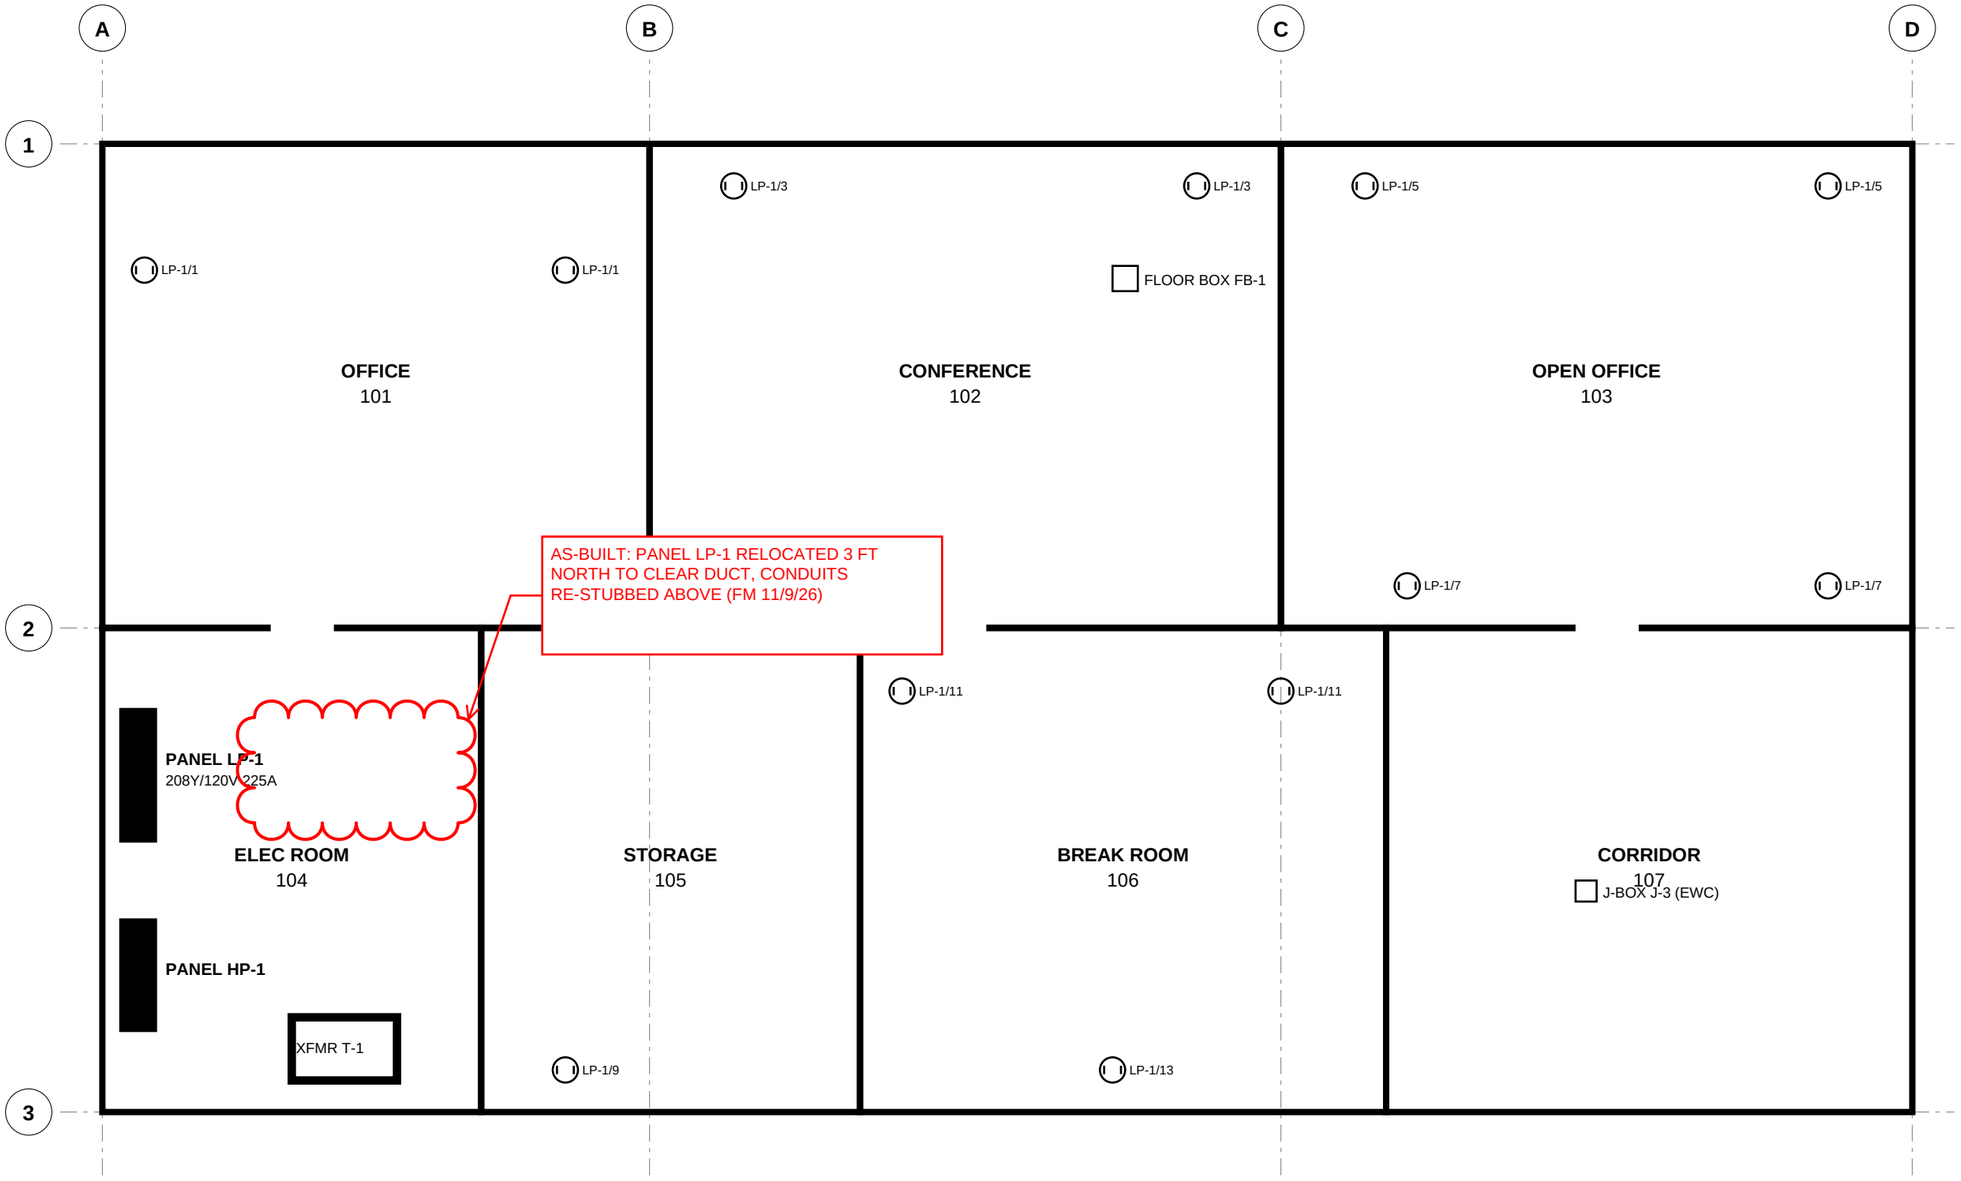


**GENERAL NOTES:**

1. ALL RECEPTACLES 18" AFF UNLESS NOTED.
2. HOME RUNS TO PANEL LP-1 IN ELEC ROOM 104.
3. COORDINATE FLOOR BOX FB-1 WITH FURNITURE PLAN.

**SAMPLE ENGINEERING CO.**
(fictional - demo only)

**PROJECT:**
Sample Tenant Fit-Out
123 Example St, Anytown

**SAMPLE DRAWING**
**NOT FOR CONSTRUCTION**

DATE: 2026-11-09 SCALE: 1/8" = 1'-0"

**FIRST FLOOR POWER PLAN**

SHEET NUMBER:

# E-101




LIGHTING CONTROL: OCC SENSOR IN EACH ROOM. EMERGENCY FIXTURES ON CKT LP-1/20.

**SAMPLE ENGINEERING CO.**
(fictional - demo only)

**PROJECT:**
Sample Tenant Fit-Out
123 Example St, Anytown

**SAMPLE DRAWING**
**NOT FOR CONSTRUCTION**

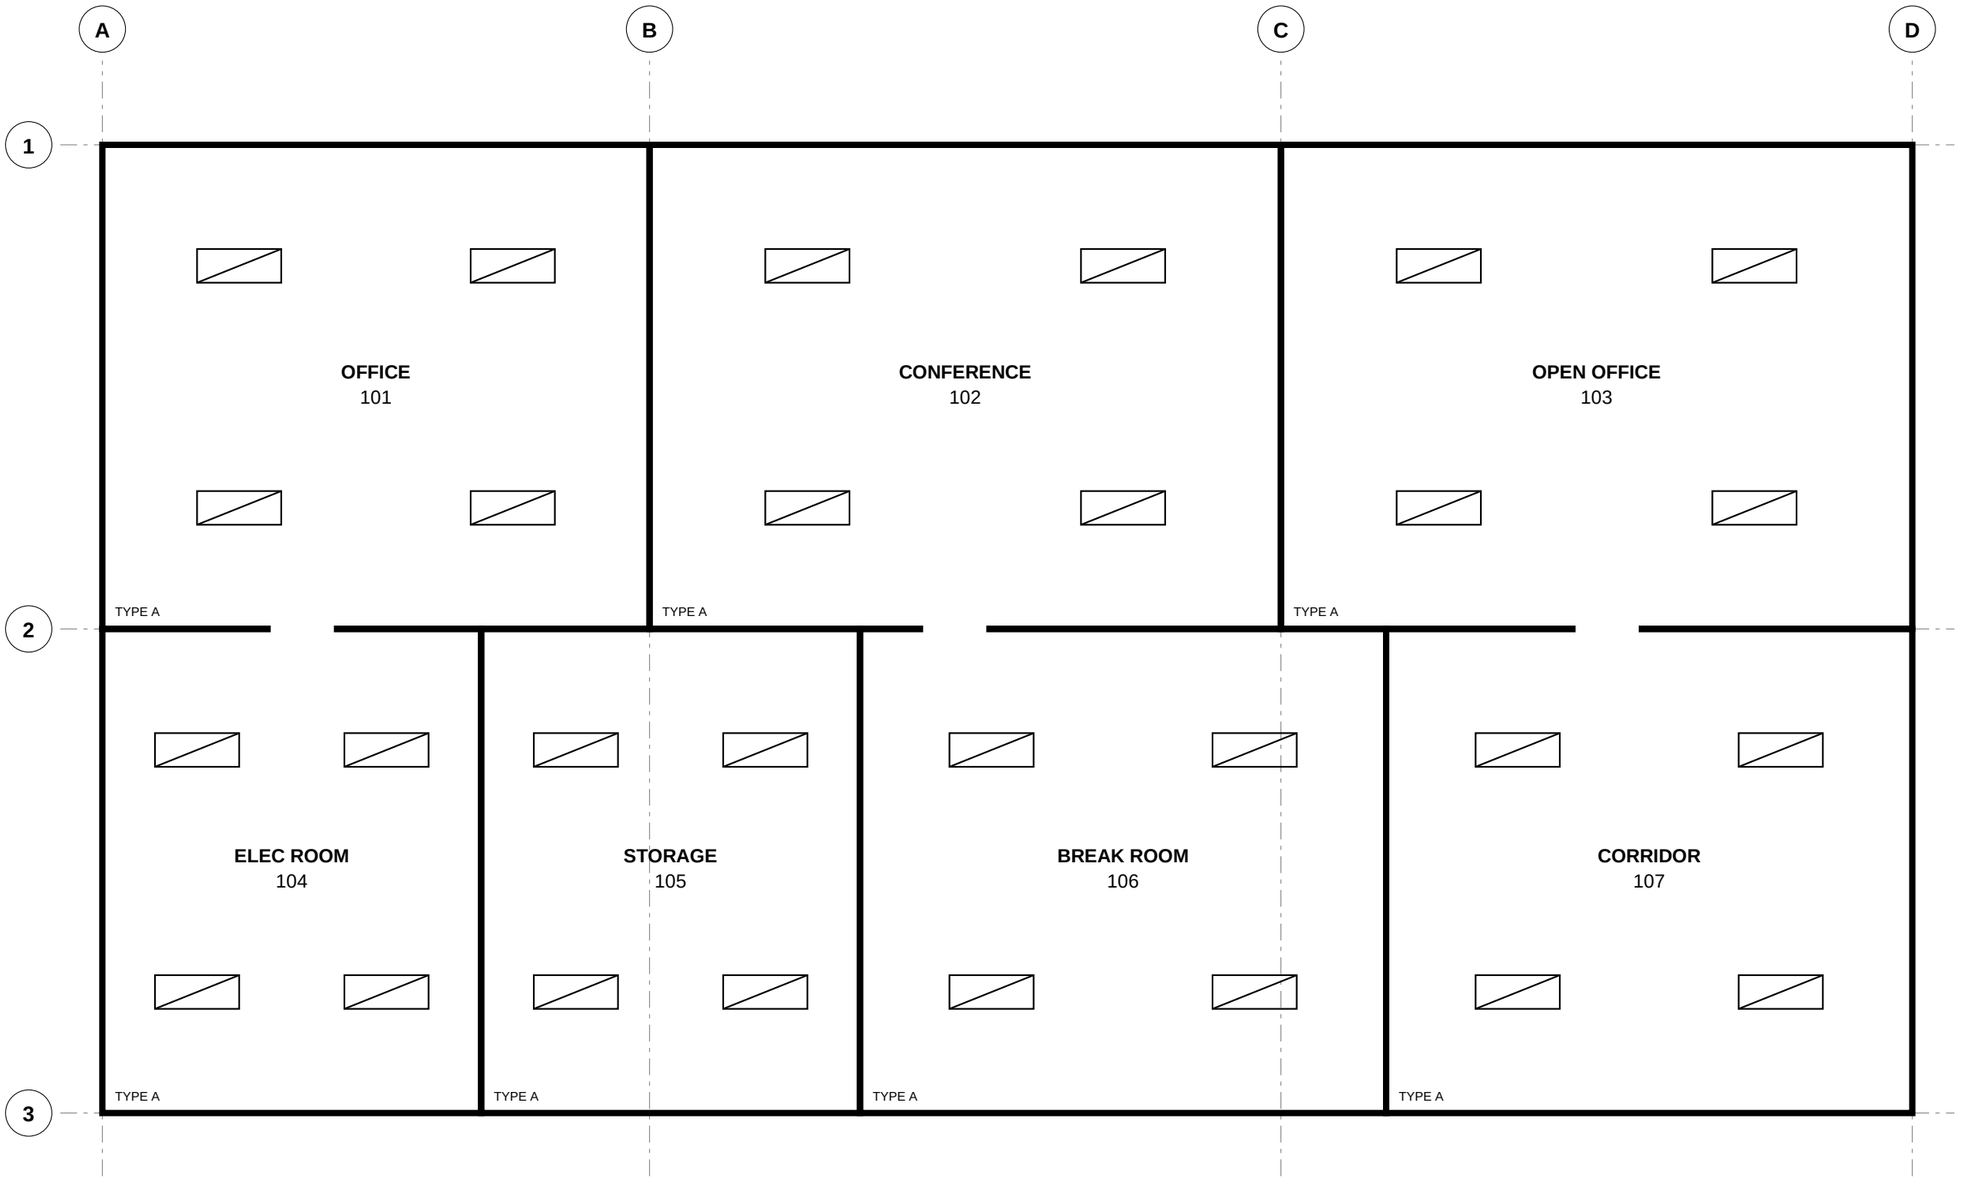DATE: 2026-11-09 SCALE: 1/8" = 1'-0"

**FIRST FLOOR LIGHTING PLAN**

SHEET NUMBER:

# E-201

# Markup log: E2E test project - as-built record

Full set: Sample electrical set E-101/E-201 (SAMPLE) - 1 markup(s), grouped by capture date (America/New_York). Generated 2026-11-09 14:35 UTC.

## 2026-11-09  (1)

| Time | Sheet | Status | By / Confirmed | Markup text |
|---|---|---|---|---|
| 9:34 AM | E-101 | **CONFIRMED** | FM / PE | AS-BUILT: PANEL LP-1 RELOCATED 3 FT NORTH TO CLEAR DUCT, CONDUITS RE-STUBBED ABOVE (FM 11/9/26) |