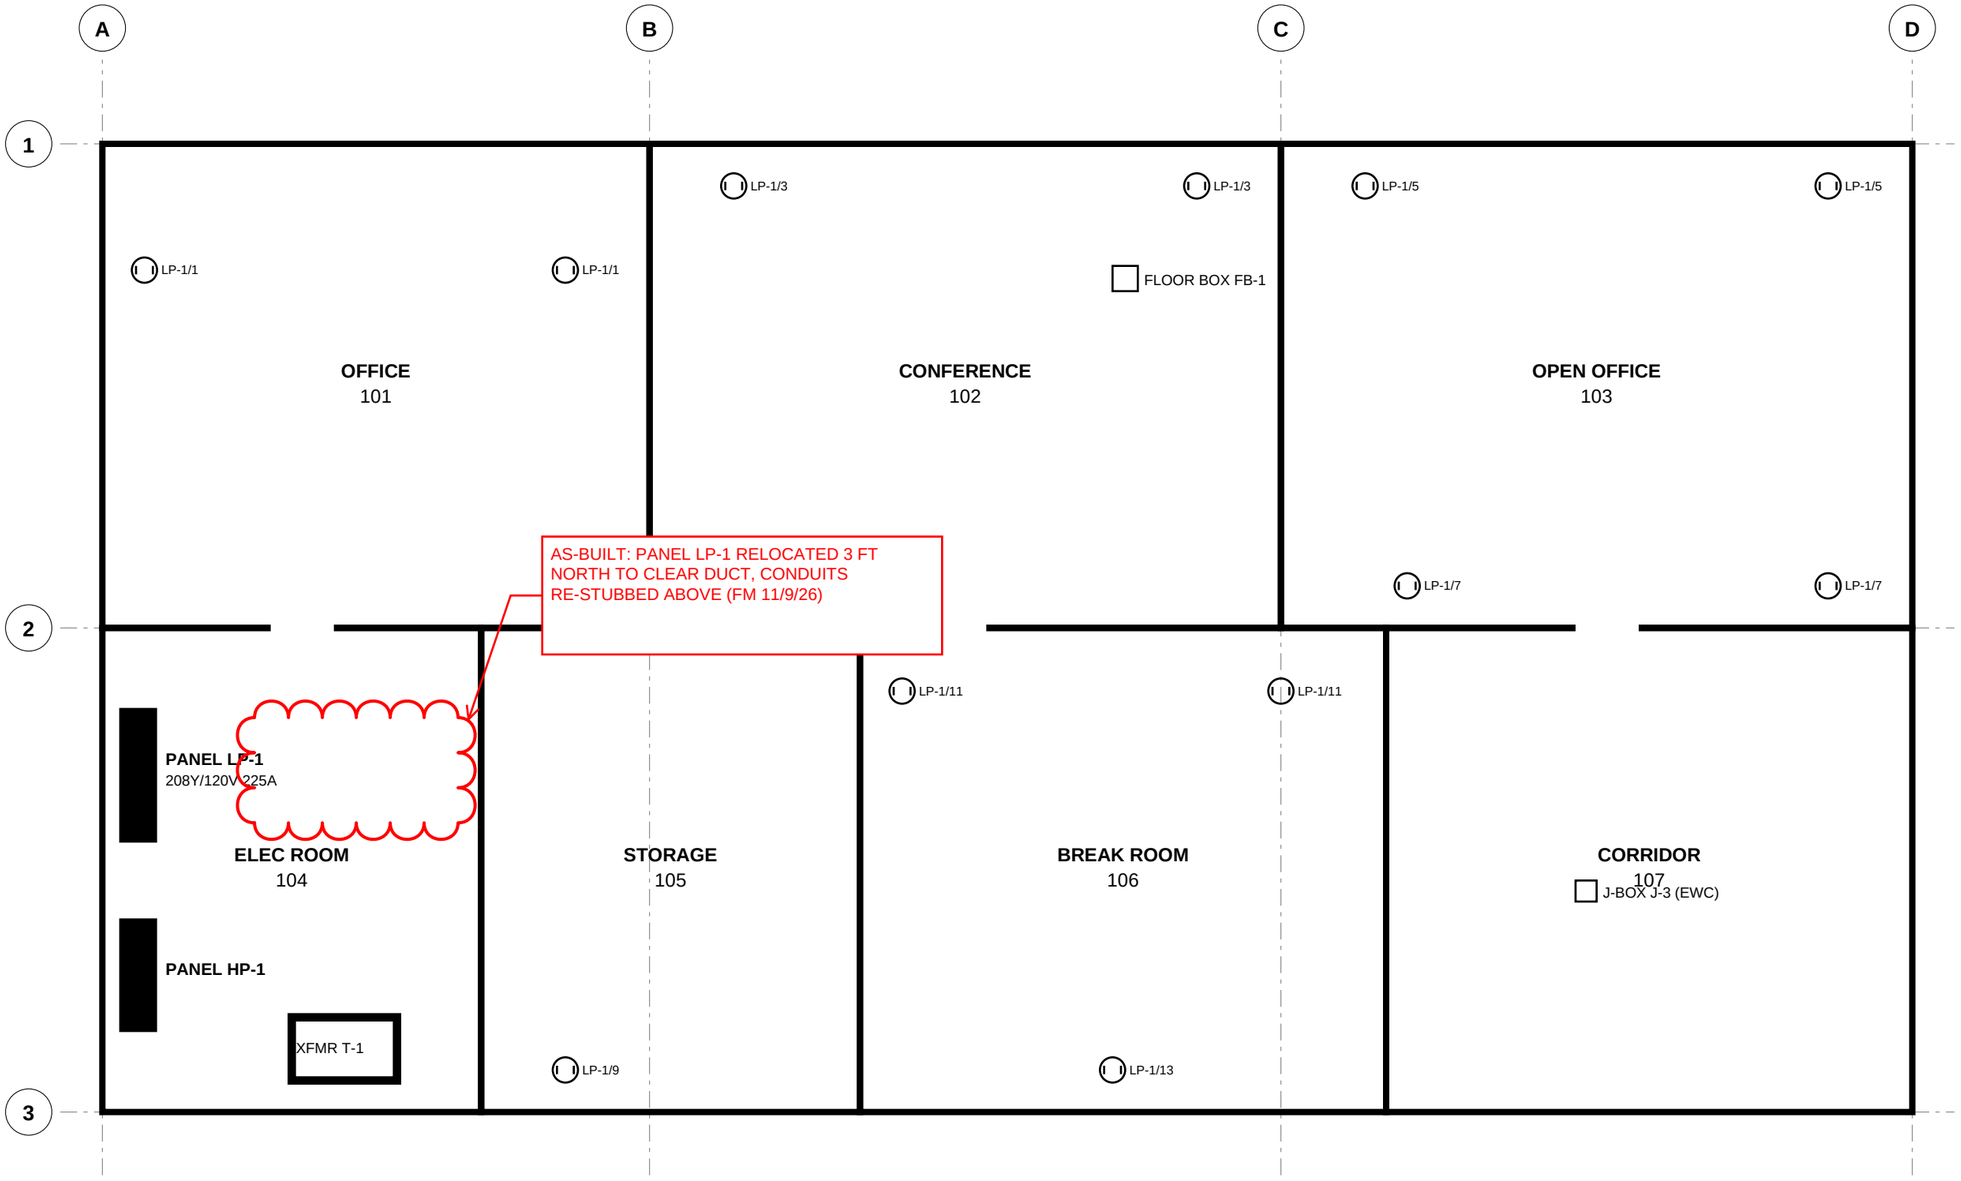

GENERAL NOTES:

1. ALL RECEPTACLES 18" AFF UNLESS NOTED.
2. HOME RUNS TO PANEL LP-1 IN ELEC ROOM 104.
3. COORDINATE FLOOR BOX FB-1 WITH FURNITURE PLAN.

SAMPLE ENGINEERING CO.
(fictional - demo only)

PROJECT:
Sample Tenant Fit-Out
123 Example St, Anytown

SAMPLE DRAWING
NOT FOR CONSTRUCTION

DATE: 2026-11-09 SCALE: 1/8" = 1'-0"

FIRST FLOOR POWER PLAN

SHEET NUMBER:

E-101

Markup log: E2E test project - as-built record

Sheet E-101 - 1 markup(s), grouped by capture date (America/New_York). Generated 2026-11-09 14:35 UTC.

2026-11-09 (1)

Time	Sheet	Status	By / Confirmed	Markup text
9:34 AM	E-101	**CONFIRMED**	FM / PE	AS-BUILT: PANEL LP-1 RELOCATED 3 FT NORTH TO CLEAR DUCT, CONDUITS RE-STUBBED ABOVE (FM 11/9/26)