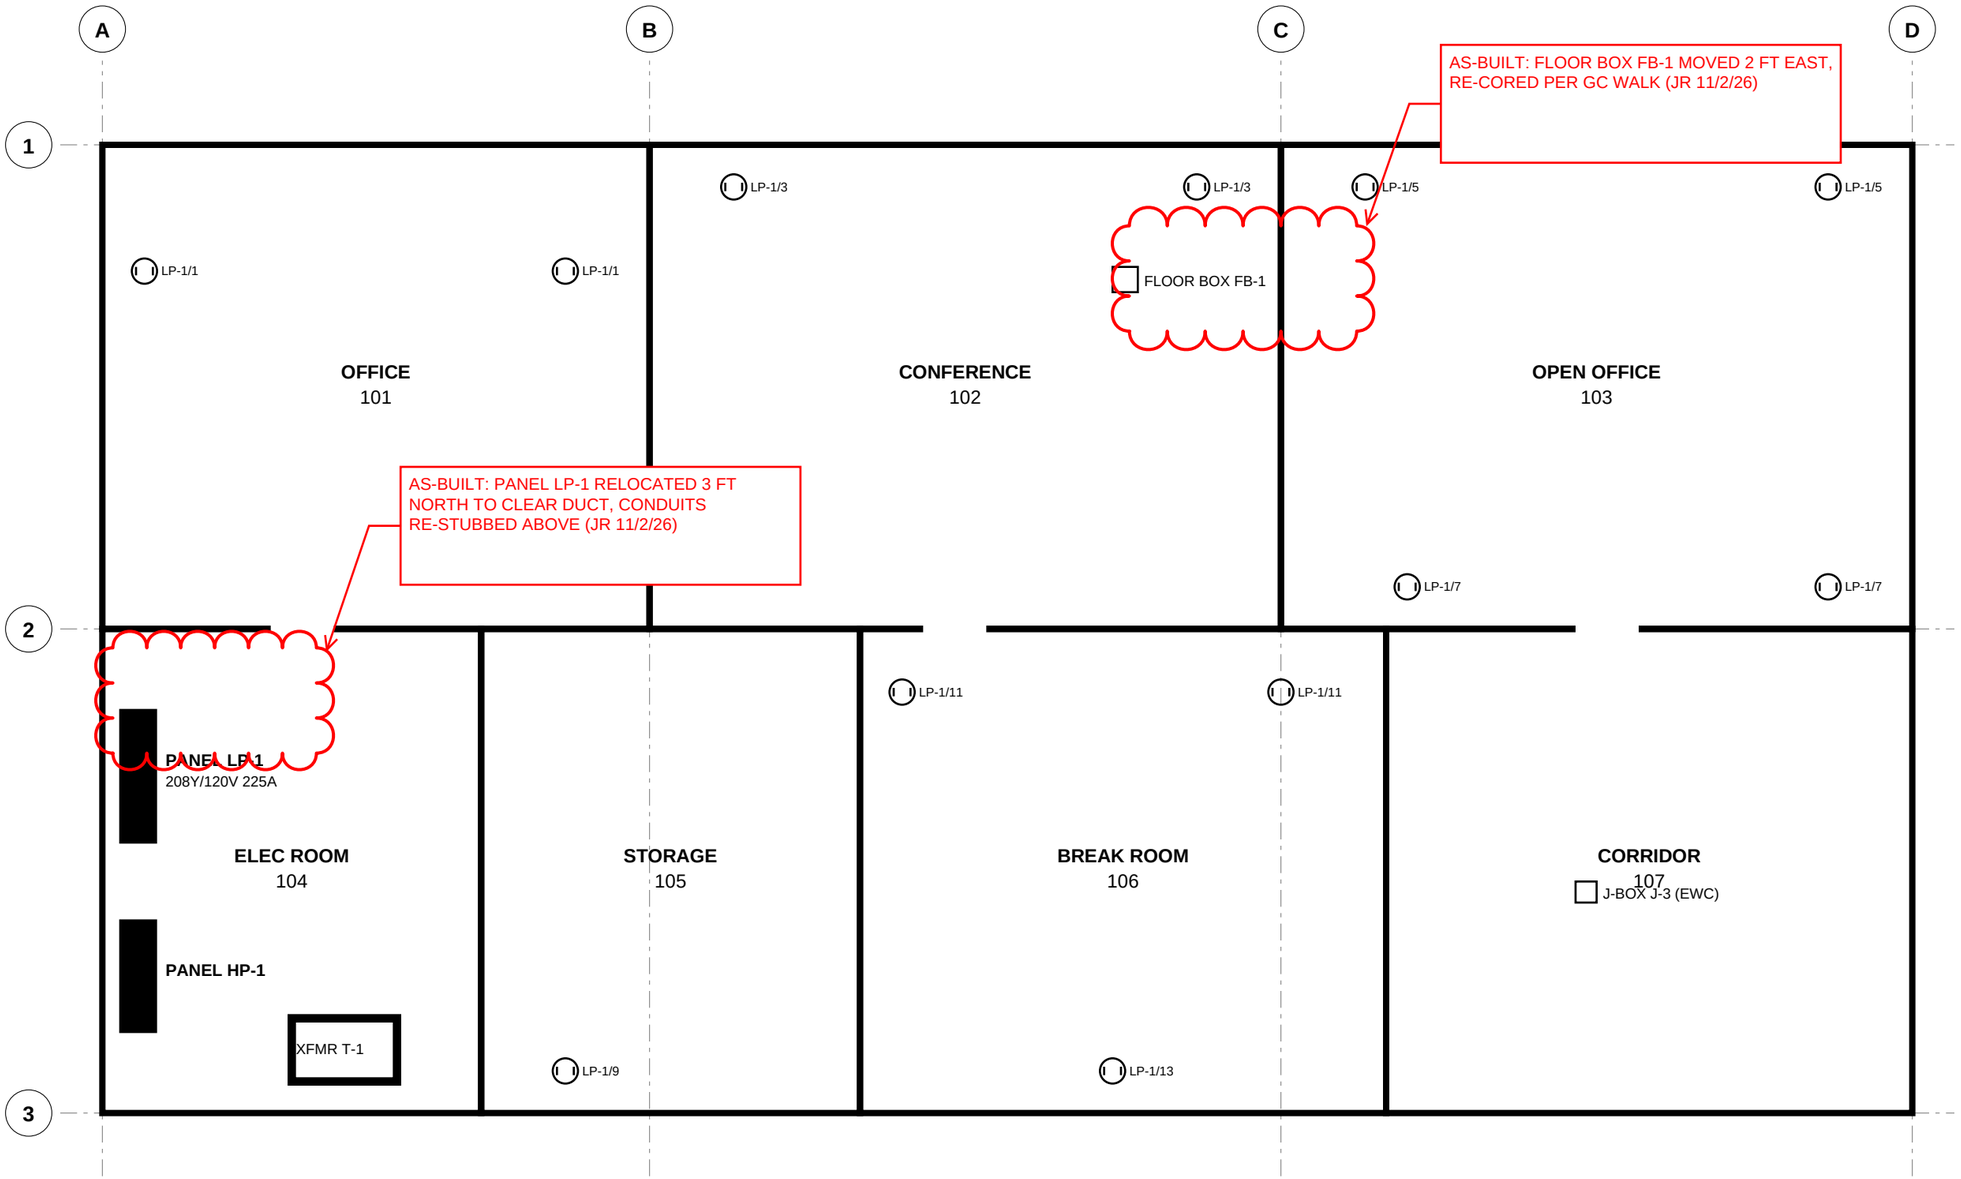

GENERAL NOTES:

1. ALL RECEPTACLES 18" AFF UNLESS NOTED.
2. HOME RUNS TO PANEL LP-1 IN ELEC ROOM 104.
3. COORDINATE FLOOR BOX FB-1 WITH FURNITURE PLAN.

SAMPLE ENGINEERING CO.
(fictional - demo only)

PROJECT:
Sample Tenant Fit-Out
123 Example St, Anytown

SAMPLE DRAWING
NOT FOR CONSTRUCTION

DATE: 2026-11-09 SCALE: 1/8" = 1'-0"

FIRST FLOOR POWER PLAN

SHEET NUMBER:

E-101

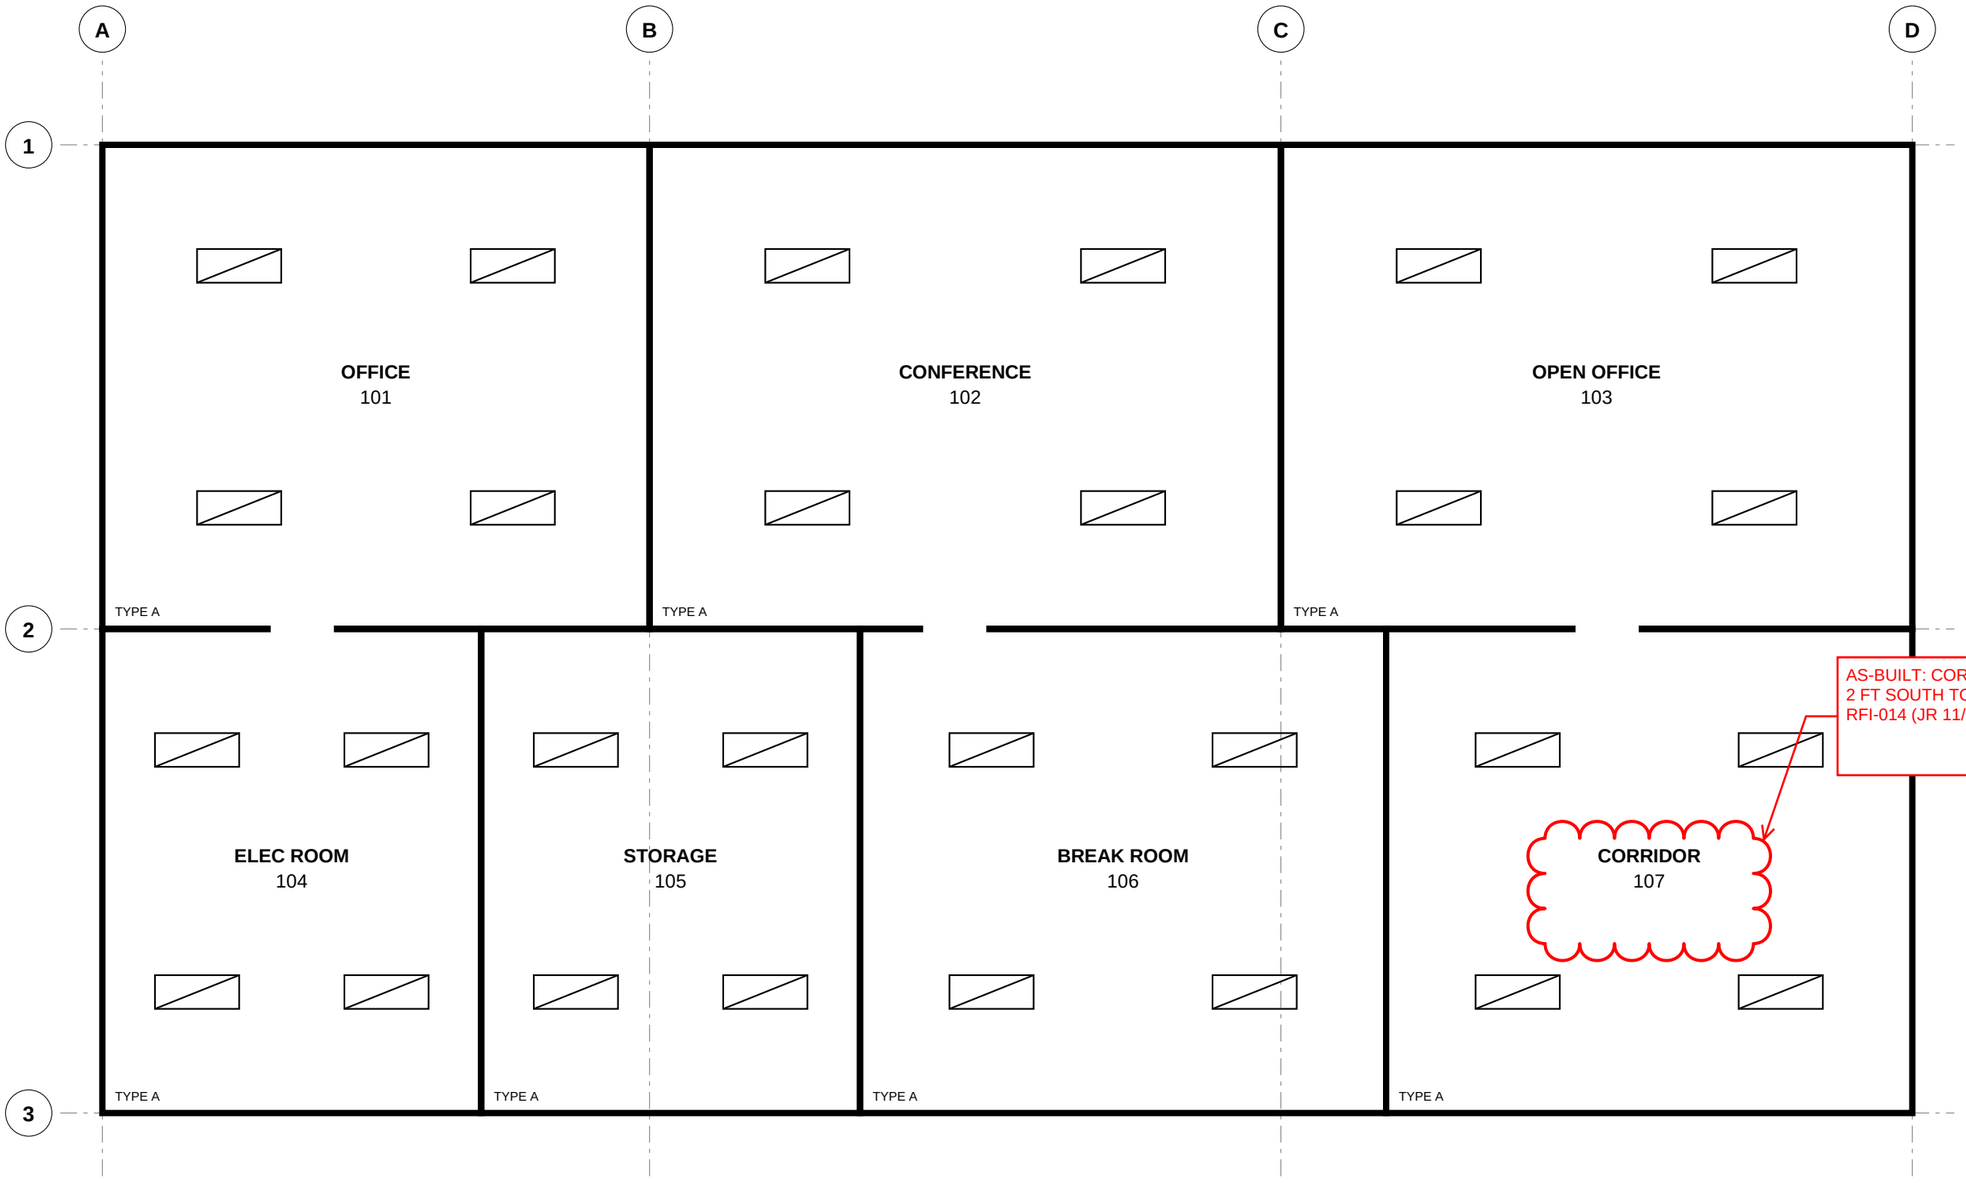

LIGHTING CONTROL: OCC SENSOR IN EACH ROOM. EMERGENCY FIXTURES ON CKT LP-1/20.

SAMPLE ENGINEERING CO.
(fictional - demo only)

PROJECT:
Sample Tenant Fit-Out
123 Example St, Anytown

SAMPLE DRAWING
NOT FOR CONSTRUCTION

DATE: 2026-11-09 SCALE: 1/8" = 1'-0"

FIRST FLOOR LIGHTING PLAN

SHEET NUMBER:

E-201

Markup log: Sample Tenant Fit-Out (SAMPLE) - as-built record

Full set: Sample electrical set E-101/E-201 (SAMPLE) - 3 markup(s), grouped by capture date (America/New_York). Generated 2026-11-09 20:18 UTC.

2026-11-02 (2)

Time	Sheet	Status	By / Confirmed	Markup text
9:20 AM	E-101	**CONFIRMED**	JR / KL	AS-BUILT: PANEL LP-1 RELOCATED 3 FT NORTH TO CLEAR DUCT, CONDUITS RE-STUBBED ABOVE (JR 11/2/26)
1:45 PM	E-101	**CONFIRMED**	JR / KL	AS-BUILT: FLOOR BOX FB-1 MOVED 2 FT EAST, RE-CORED PER GC WALK (JR 11/2/26)

2026-11-05 (1)

Time	Sheet	Status	By / Confirmed	Markup text
8:10 AM	E-201	**CONFIRMED**	JR / KL	AS-BUILT: CORRIDOR 107 FIXTURES SHIFTED 2 FT SOUTH TO CLEAR SPRINKLER MAIN, RFI-014 (JR 11/5/26)